



- DRAWING NOTES: (APPLY TO THIS DWG. ONLY)
1. ALL RETURN AND EXHAUST REGISTERS ARE 8" X 4" UNLESS OTHERWISE NOTED.
 2. ALL SUPPLY DIFFUSERS ARE 6" X 6" UNLESS OTHERWISE NOTED.
 3. ALL SUPPLY DIFFUSERS SHALL BE 4-WAY BLOW UNLESS OTHERWISE INDICATED.
 4. ALL SUPPLY DIFFUSERS ARE TYPE "A" UNLESS OTHERWISE NOTED.
 5. ALL RETURN AND EXHAUST REGISTERS ARE TYPE "A" UNLESS OTHERWISE NOTED.
 6. ALL TERMINAL BOXES IN INTERSTITIAL SPACE SHALL HAVE ACCESS LOCATED ON TOP OF BOX EXCEPT FOR BOXES LOCATED IN ZONE 2 OR AS OTHERWISE INDICATED.
- SPECIAL NOTES: (APPLY TO THIS DWG. ONLY)
1. 2'-0" LONG TWO-SLOT LINEAR DIFFUSER, TYPE "C" WITH 2'-0" LONG X 6" ADJUST DIFFUSER SO THAT ONE SLOT BLOWS TOWARDS WINDOW.
 2. SAME AS 1 EXCEPT BLANCE FOR 115 CFM.
 3. DUCT DISTRIBUTION IDENTICAL TO THAT SERVING 38117.
 4. DUCT DISTRIBUTION IDENTICAL TO THAT SERVING 38130.
 5. STATIC PRESSURE SENSOR (TWO REQUIRED FOR 1-AC.6).
 6. MINIMUM 80 CFM.
 7. MINIMUM 70 CFM.
 8. OCCUPIED/UNOCCUPIED CONTROL.
 9. 12 X 10 DUCT DN. TO H-1-46, 815 CFM WITH V.D.

ROOM NO.	ROOM NAME	ROOM NO.	ROOM NAME
38107	RES. STOR.	38143	1 BED ROOM
38108	X-RAY STOR.	38144	W.C. 1 BED ROOM
38109	HEAD NURSE OFFICE	38145	1 BED ROOM
38110	STORAGE RM	38146	1 BED ROOM
38111	STORAGE RM	38147	1 BED ROOM
38112	STORAGE RM	38148	1 BED ROOM
38113	CLEAN LINEN STOR.	38149	1 BED ROOM
38114	STORAGE UTILITY	38150	1 BED ROOM
38115	STORAGE UTILITY	38151	1 BED ROOM
38116	STORAGE UTILITY	38152	1 BED ROOM
38117	STORAGE UTILITY	38153	1 BED ROOM
38118	STORAGE UTILITY	38154	1 BED ROOM
38119	STORAGE UTILITY	38155	1 BED ROOM
38120	STORAGE UTILITY	38156	1 BED ROOM
38121	STORAGE UTILITY	38157	1 BED ROOM
38122	STORAGE UTILITY	38158	1 BED ROOM
38123	STORAGE UTILITY	38159	1 BED ROOM
38124	STORAGE UTILITY	38160	1 BED ROOM
38125	STORAGE UTILITY	38161	1 BED ROOM
38126	STORAGE UTILITY	38162	1 BED ROOM
38127	STORAGE UTILITY	38163	1 BED ROOM
38128	STORAGE UTILITY	38164	1 BED ROOM
38129	STORAGE UTILITY	38165	1 BED ROOM
38130	STORAGE UTILITY	38166	1 BED ROOM
38131	STORAGE UTILITY	38167	1 BED ROOM
38132	STORAGE UTILITY	38168	1 BED ROOM
38133	STORAGE UTILITY	38169	1 BED ROOM
38134	STORAGE UTILITY	38170	1 BED ROOM
38135	STORAGE UTILITY	38171	1 BED ROOM
38136	STORAGE UTILITY	38172	1 BED ROOM
38137	STORAGE UTILITY	38173	1 BED ROOM
38138	STORAGE UTILITY	38174	1 BED ROOM
38139	STORAGE UTILITY	38175	1 BED ROOM
38140	STORAGE UTILITY	38176	1 BED ROOM
38141	STORAGE UTILITY	38177	1 BED ROOM
38142	STORAGE UTILITY	38178	1 BED ROOM

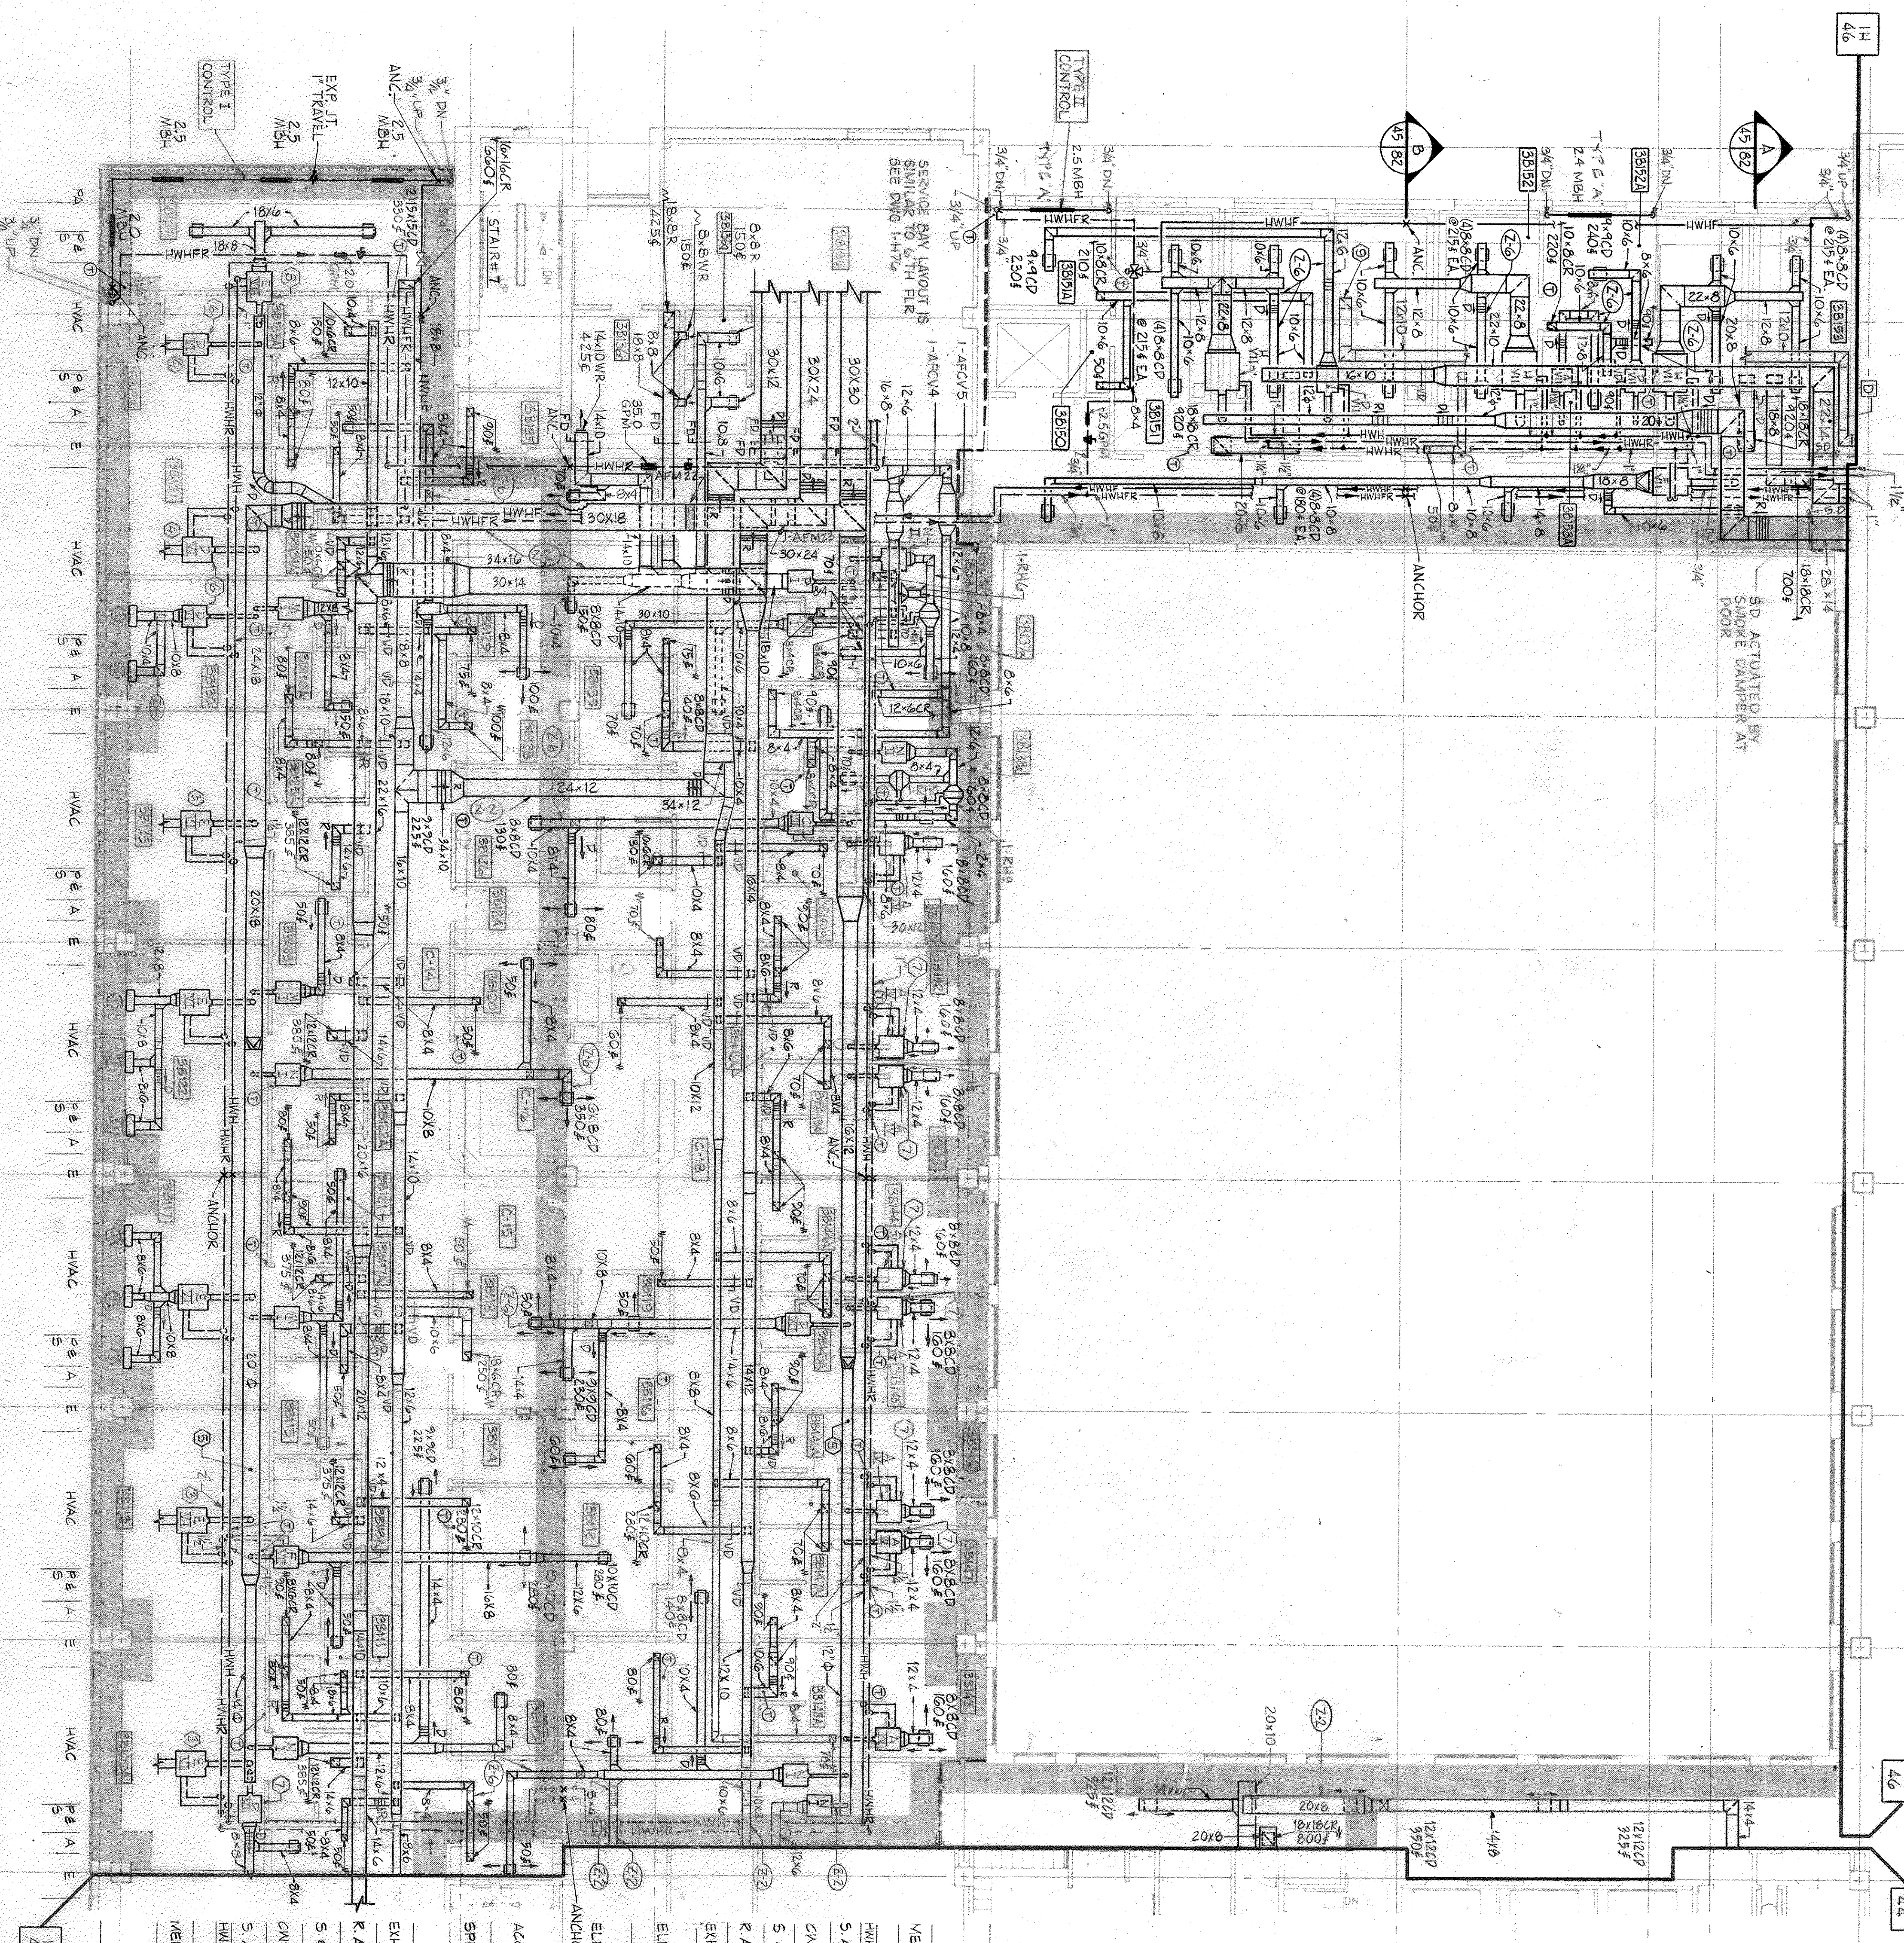


RECORD DRAWING
CORRECTED ON BASIS OF DATA
FINISHED BY THE DESIGNER (11/1/88)

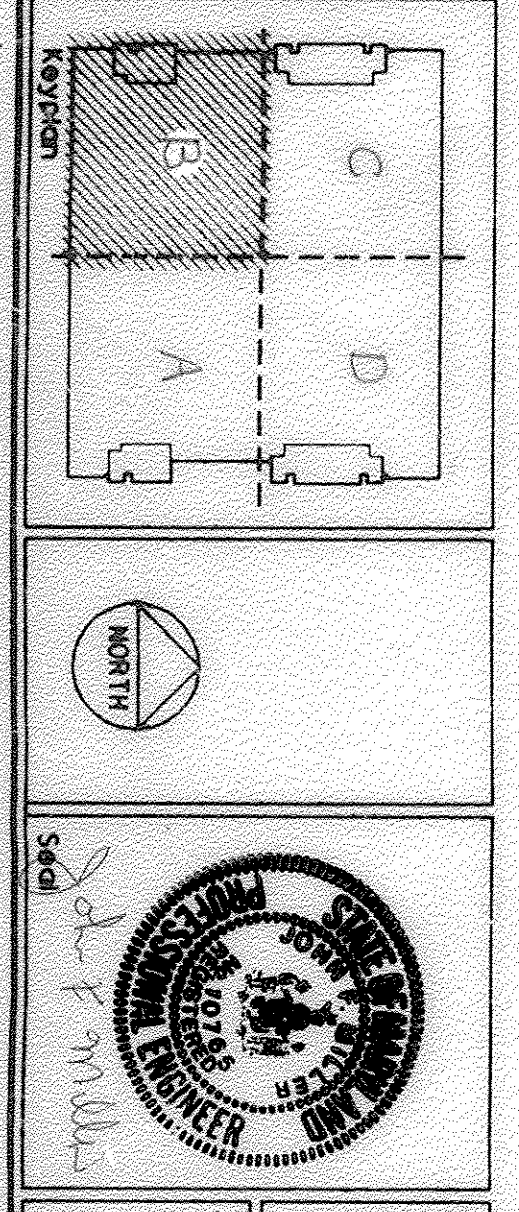

RTK/CS&D/HENRY ADAMS (J.V.)
ARCHITECTS AND ENGINEERS
400 E. PRATT STREET
BALTIMORE, MD 21202

Approved Project Director
[Signature]

Scale 1/8" = 1'-0"	Building Number 324 - BED REPLACEMENT HOSPITAL - PHASE II	Date 9/1/88
Checked VAMC - BALTIMORE, MD.	Project Title 3RD FLOOR PLAN AREA B	Project No. 511-0010
		Drawn By 1-1445
		Veterans Administration

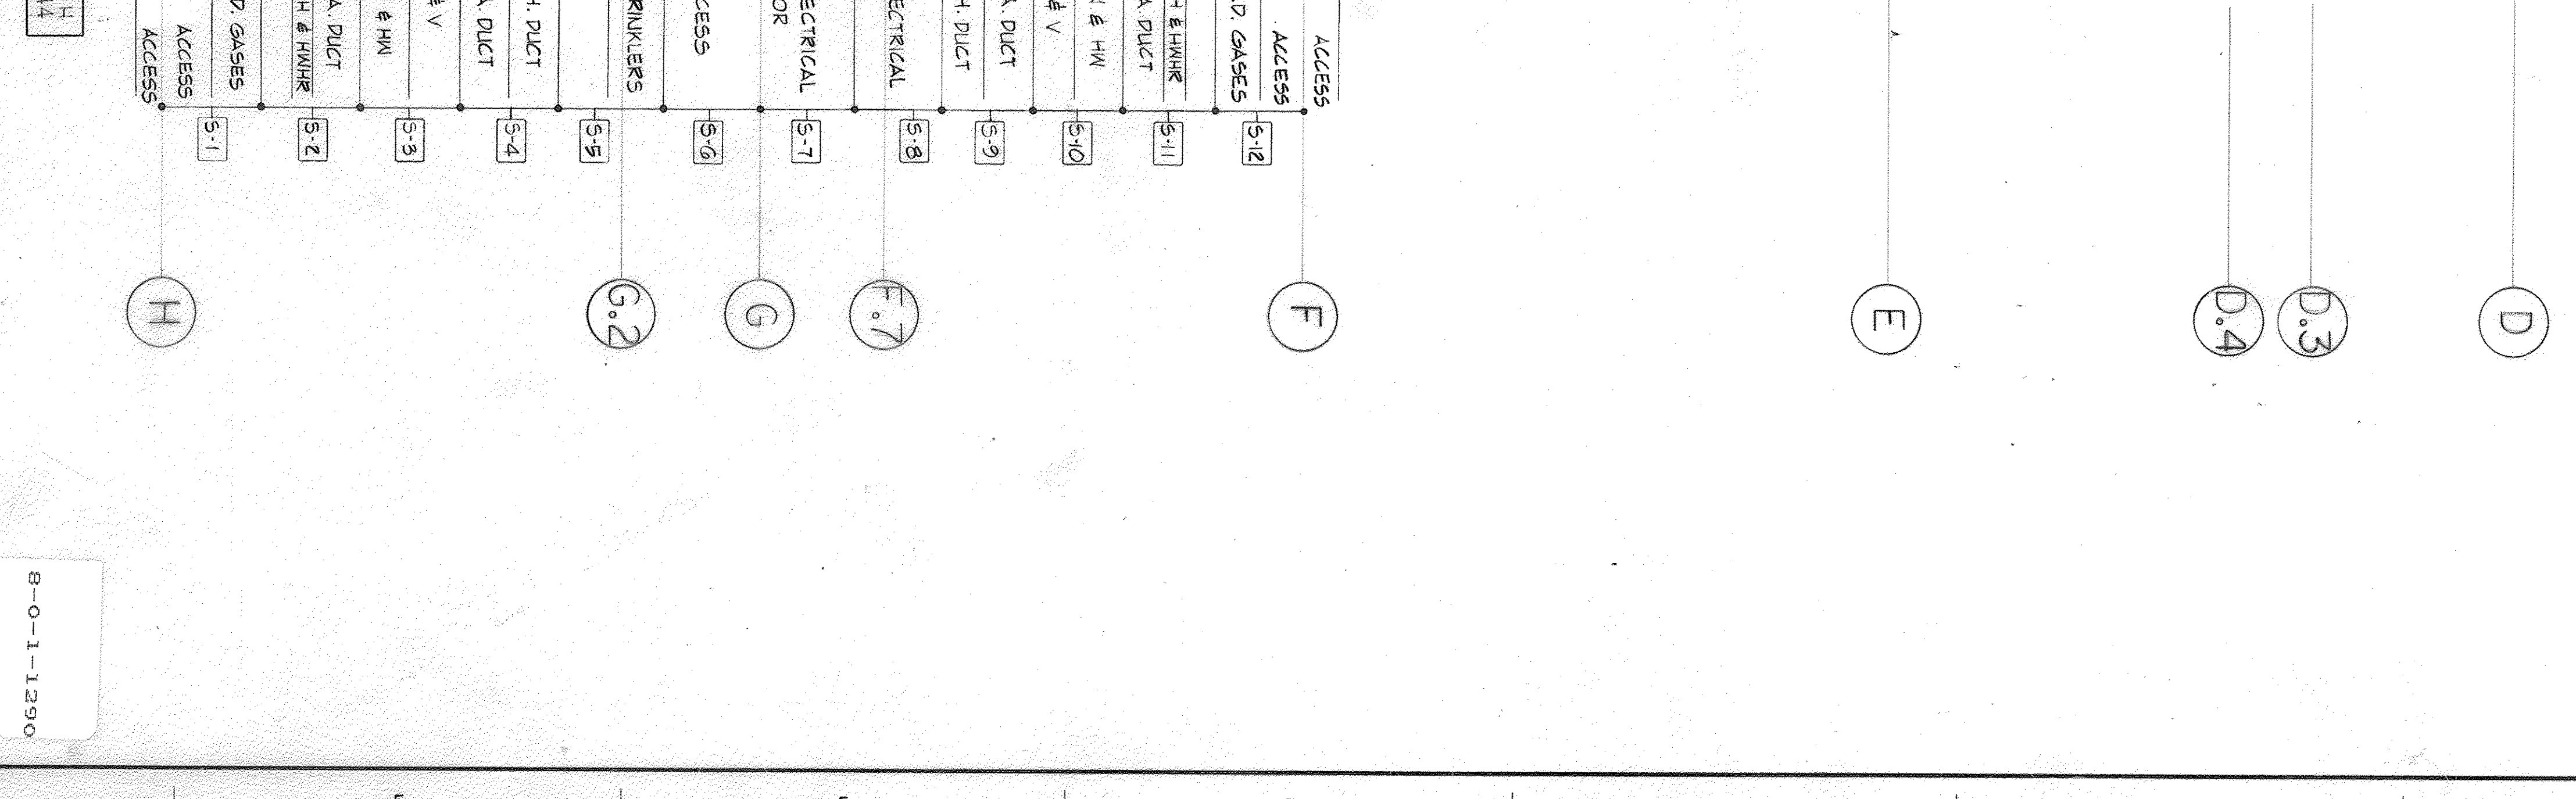

B-0-1-1290